Monday, 5/26/2008 1:09:44 PM

Chantal Lavoie

#### **Process Sheet**

Customer

: CU-DAR001 Dart Helicopters Services

Type

S.O. No. :

Job Number

: 39493

**Estimate Number** : 13100

P.O. Number

This Issue

: 5/26/2008

: 38504

: NC Prsht Rev. : 11

First Issue **Previous Run** 

Written By

Checked & Approved By

Comment

: Est. Rev. A 07/12/13 DL verified by:DD

: THERMOFORMING

**Drawing Name** 

: PANEL-350 UPPER BULKHEAD

Part Number

: D36553

**Drawing Number** Project Number : D3655 UNDER REVIEW 08.05.06

: 00204

**Drawing Revision** : A

Material

**Due Date** : 5/27/2008

Qty:

1 Um:

Each

**Additional Product** 

Job Number:



Seq. #:

2.0

3.0

4.0

Machine Or Operation:

Description: GE PLASTICS LEXAN SHEET

34.6600 sf(s)

MLEXS093F600607 1.0

Comment: Qty.: 34.6600 sf(s)/Unit Total: GE PLASTICS LEXAN SHEET

batch: M107574

HAND FINISHING THERMOFORMING

THERMOFORMING MACHINE



Comment: HAND FINISHING THERMOFORMING

1) Cut Blanks to fit frame size THERMOFORMING



Comment: THERMOFORMING MACHINE

Thermoform as per Dwg. D3655-3and Folio FTA 017 using tool DT 8985

Dwg. Rev. Folio Rev.

INSPECT PARTS AS THEY COME OFF MACHINE



Comment: INSPECT PARTS AS THEY COME OFF MACHINE

Visually inspect for proper formation of each part

Dh. 08.05.26.

The 08.05.26.

## **Dart Aerospace Ltd**

W/O:		WORK ORDER CHANGES							
DATE	STEP	PROCEDURE CHANGE	Ву	Date	Qty	Approval Chief Eng / Prod Mgr	Approval QC Inspector		
							=		
Part No	:	PAR #: Fault Category:	NCR: Yes	No DO	Δ.	Date:	L		

Part No:	PAR #: Fault Category:	NCR: Yes No DQA: Date:
		QA: N/C Closed: Date:
NCR:	WORK ORDER NON-C	CONFORMANCE (NCR)

NCR:			WORK ORD	ER NON-CONFORMAN	CE (NCR)									
5475		Description of NC	Description of NC Corrective Action Section B Verification				Corrective Action Section B		Corrective Action Section B		Description of NC		Approval	Approval
DATE	STEP	Section A	Initial Chief Eng	Action Description Chief Eng	Sign & Date	Section C	Approval Chief Eng	Approval QC Inspector						
E _														
								6						

NOTE: Date & initial all entries

Monday, 5/26/2008 1:09:44 PM Date: Chantal Lavoie User: **Process Sheet** Drawing Name: PANEL-350 UPPER BULKHEAD Customer: CU-DAR001 Dart Helicopters Services Part Number: D36553 Job Number: 39493 Job Number: Description: Seq. #: **Machine Or Operation:** SECOND CHECK QC8 5.0 Comment: SECOND CHECK HAND FINISH TH HAND FINISHING THERMOFORMING 6.0 Comment: HAND FINISHING THERMOFORMING 1) Trim to Finished Dimensions as per dwg D3655 7.0 QC2 INSPECT PARTS AS THEY COME OFF MACHINE Comment: INSPECT PARTS AS THEY COME OFF MACHINE Check dimensions to ensure conformity to drawing tolerances. INSPECT WORK TO CURRENT STEP QC5 8.0 Comment: INSPECT WORK TO CURRENT STEP PACKAGING RESOURCE #1 PACKAGING 1 9.0 Comment: PACKAGING RESOURCE #1 Identify and Stock Location: FINAL INSPECTION/W/O RELEASE QC21 10.0 Comment: FINAL INSPECTION/W/O RELEASE Job Completion


# **Dart Aerospace Ltd**


W/O:		WORK ORDER CHANGES	WORK ORDER CHANGES					
DATE	STEP	PROCEDURE CHANGE	Ву	Date	Qty	Approval Chief Eng / Prod Mgr	Approval QC Inspector	

Part No: <u>D3655-3</u>	PAR #:	Fault Category:	NCR: Yes No DQA:	Date: <u>∂8/05</u> ∫
			QA: N/C Closed:	Date:

NCR: 3	9493		WORK OR	DER NON-CONFORMANC	E (NCR)			
		Description of NC		Corrective Action Section B			Approval	Approval
DATE	STEP	Section A	<b>Initial</b> Chief Eng	Action Description Chief Eng	Sign & Date	Verification Section C	Chief Eng	Approval QC Inspector
pd 08.05.26	6	DFMS 20.9 and 44.5  Were  0.5.45 19.9 and 45.5  are 20.9 and 44.5	08.05.26	ACLEPTABLE DEVIATION  (SEE ATTACHED)	PL. 68,05.24	16805-27	01.05.26	100-25-27
	1							
								ı

NOTE: Date & initial all entries

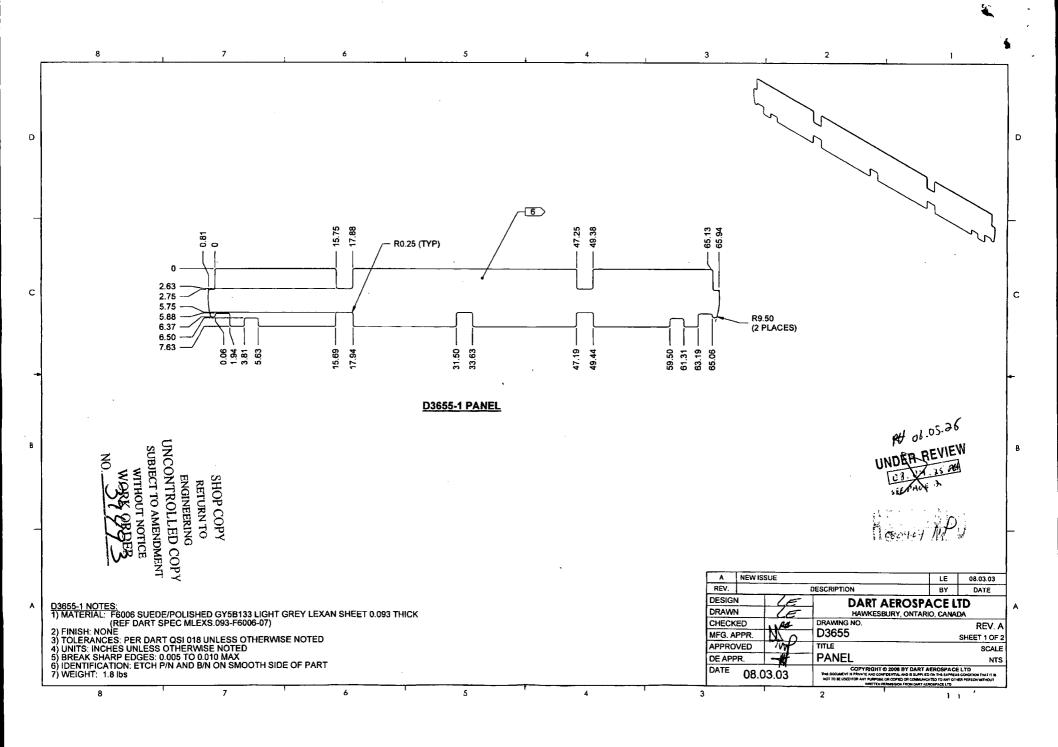

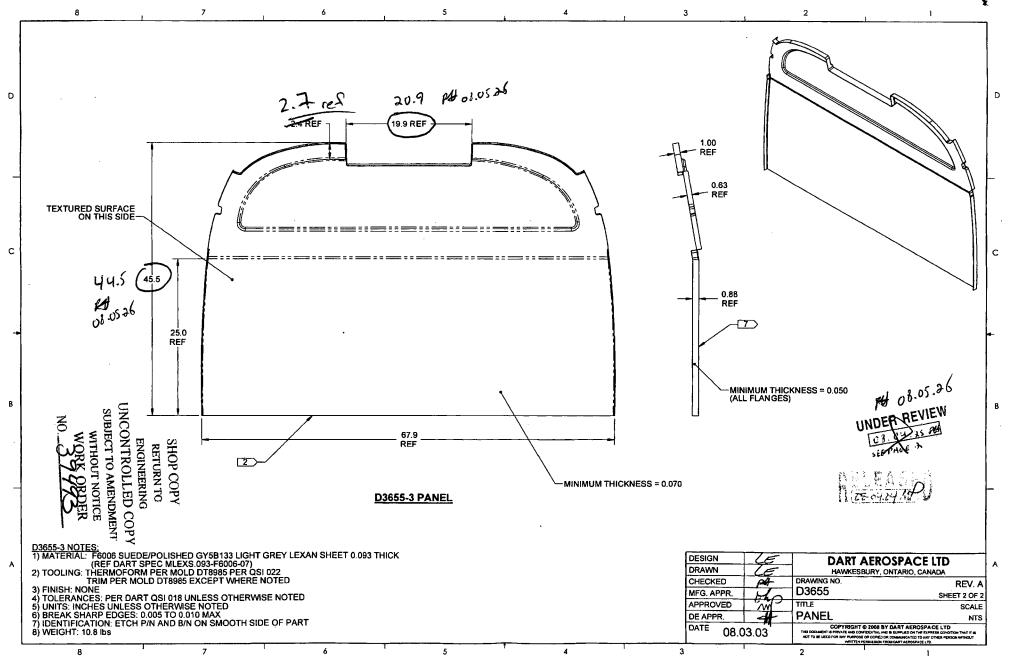

#### **Peter Hum**

From:

Chris Provencal [cprovencal@dartaero.com]

Sent:

April 24, 2008 8:57 AM

To:

Peter Hum

Subject:

FW: NCR D3655-3

Attachments:

Image1.jpg; D3655-RevA.pdf





Image1.jpg (57 KB) D3655-RevA.pdf (118 KB)

From: David Shepherd [mailto:dshepherd@dartaero.com]

Sent: April 11, 2008 3:31 PM

To: 'Chris Provencal'

Cc: 'Mike Petsche'; 'Leger, Daryl'; 'Bill Beckett'

Subject: FW: NCR D3655-3

Mike/Daryl,

I'm not very happy about this to say the least. We just went through the exercise of making a set of parts, trimming them to templates, conforming them to the drawings, and installing them in an aircraft. How can we have been off by 1"? This is totally unacceptable in my opinion. Someone along the line has dropped the ball. How could we have conformed the parts if

they were 1" different than the drawings?

My guess is that all fingers will be pointed to Leanne because she is no longer there to defend herself, but if the drawings were no good, then why did you both sign them???? This is the kind of stuff you should be checking. I cannot do this myself from Calgary.

Now we're going to spend more time and money updating Solidworks models and doing drawing updates. We just certified this. These types of issues should have been sorted out on conformity. That was the whole point.

Chris.

If the parts match what is in the aircraft, they will be acceptable. But I don't think we should make any more without doing a PROPER FAI and checking against the drawing.

David

From: Chris Provencal [mailto:cprovencal@dartaero.com]

Sent: Friday, April 11, 2008 7:41 AM

To: dshepherd@dartaero.com

Cc: mpetsche@dartaero.com; D Leger

Subject: NCR D3655-3

David,

For the D3655-3 Panel (350 interiors), the dwg dimension 19.9" is 20.9", dwg dimension 45.5" is 44.5". Ref attached pic. The part was made to the mold. The dwg was evidently created before the mold, and the dimensions were never updated.

The 20.9" width of the 'slot' fits with the mating part correctly; 19.9" would be too small and would have a sloppy fit. A verified this myself.

The dwg length of 45.5" is impossible to achieve from the mold. Daryl made the part as long as possible. The parts have evidently been fit into the aircraft and I'm told this dim works.

The dwg obviously needs an update. In the meantime, can we accept this deviation?

-Chris


No virus found in this incoming message. Checked by AVG. Version: 7.5.519 / Virus Database: 269.22.11/1371 - Release Date: 4/10/2008 12:23 PM

No virus found in this outgoing message.

Checked by AVG.

Version: 7.5.519 / Virus Database: 269.22.12/1373 - Release Date: 4/11/2008

9:17 AM

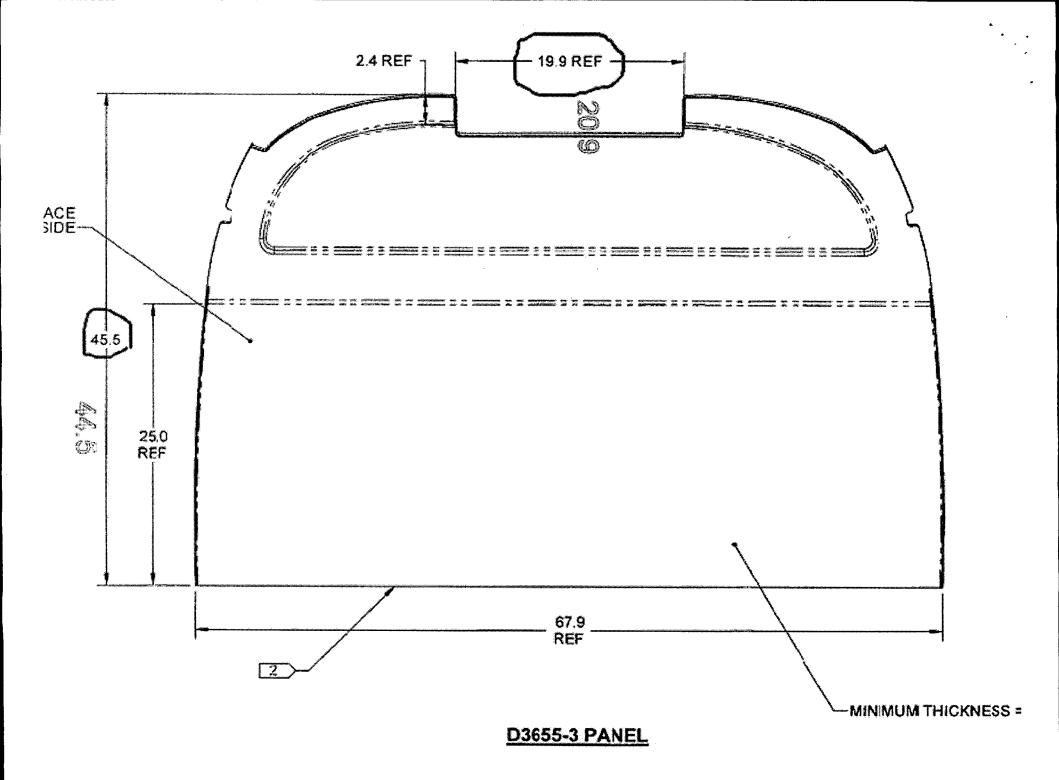

DART AEROSPACE LTD	WORK ORDER:	39493
Description:Upper Bulkhead	Part Number:	D3655-3
Inspection Dwg: 53655Rev: 4		Page 1 of 1

## FIRST ARTICLE INSPECTION CHECKLIST

First Article Prototype

(Step 4) Thermoforming Visual Inspection Sign-off

Description	Initials:
	17
Acceptable shape definition	P.L.
Free of visual flaws (bumps, cracks, voids, etc.	Win
`	ن ب
	1

# (Step 6) Trimming FAI Checklist

Inspect dimensions highlighted on inspection sheet drawing 2355 Rev. A and record below

Tolerance	Actual	Accept	Reject	Method of	Comments
	Dimension			Inspection	
					B.
0.100"	44,5	U,		<u> </u>	
0.100"	25.9	i			
0.100"	67.9				11.
030"	-	9_			
	e @34	1/		CALLPER	#:
					16
<del></del>					
<del></del>			-		11.
					1
<del></del> -					
					11:
	0.100" 0.100"	0.100" 44,5 0.100" 35,9 0.100" 47,7	0.100"	0.100"	Dimension   Inspection

^			AICHE
Measured by:	Audited by: DKy	Prototype Approval:	1UM I
Date: 08 05.26	Date: 0x/0 27</th <th>Date:</th> <th>14</th>	Date:	14
00.05:00.			基
15.		Povisod by	Approved

Rev Date Change Revised by Approved New Issue

